



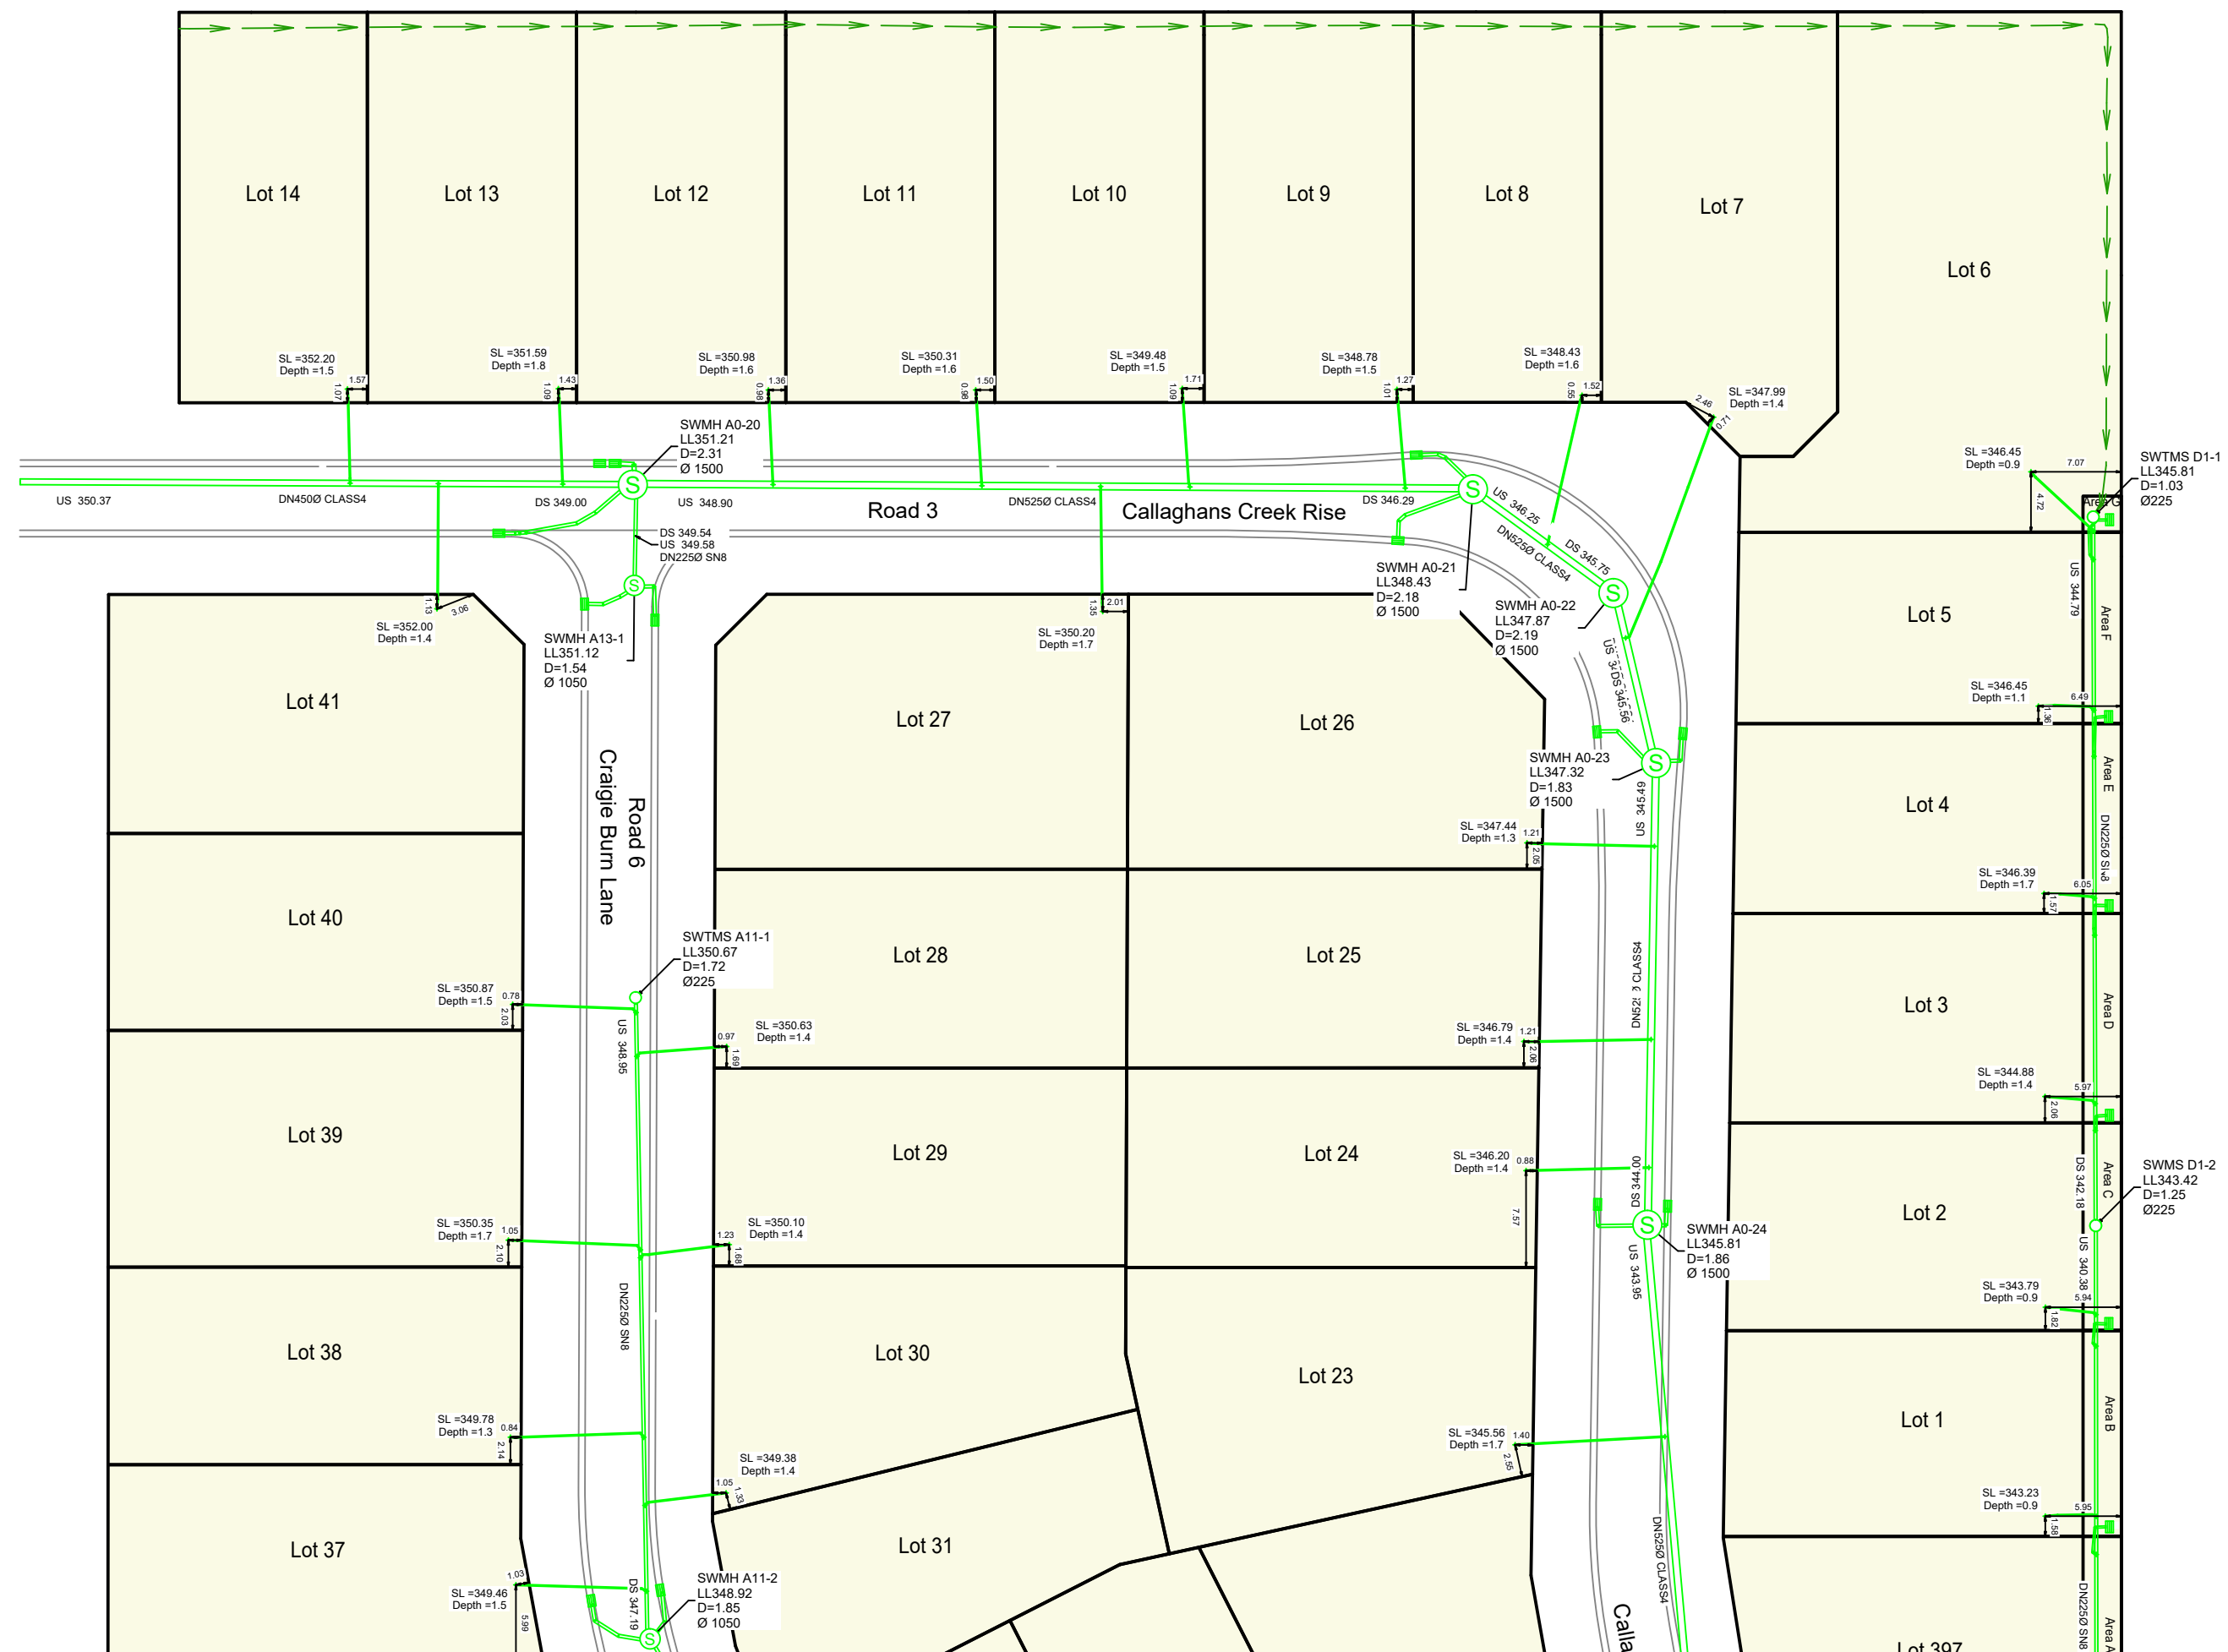

|     |  |  |  |               |          |      |      |     |          |
|-----|--|--|--|---------------|----------|------|------|-----|----------|
| 1   |  |  |  | Initial Issue | Revision | KA   | NKA  | NKA | 19/05/25 |
| No. |  |  |  | By            | Chk      | Appd | Date |     |          |

|                     |                   |                             |          |                                            |                                                  |                        |
|---------------------|-------------------|-----------------------------|----------|--------------------------------------------|--------------------------------------------------|------------------------|
| Original Scale (A1) | Drawn By          | Checked By                  | Client   | Project                                    | Title                                            | Discipline             |
| Reduced Scale (A3)  | K Adams           | N Archer                    | LANDPRO. | 21091 Stage 1 As-Built Stormwater RM220913 | WFH Properties Ltd<br>Pembroke Heights<br>Wanaka | Stormwater Page 1 of 2 |
| 1 : 500             | Origin Name       | F6LK                        |          |                                            |                                                  |                        |
|                     | Origin Coordinate | 806736.288 mN 375397.584 mE |          |                                            |                                                  |                        |
|                     | Origin of Levels  | 338.832 m VD2016            |          |                                            |                                                  |                        |

|             |     |      |   |
|-------------|-----|------|---|
| Drawing No. | 204 | Rev. | 1 |
|-------------|-----|------|---|

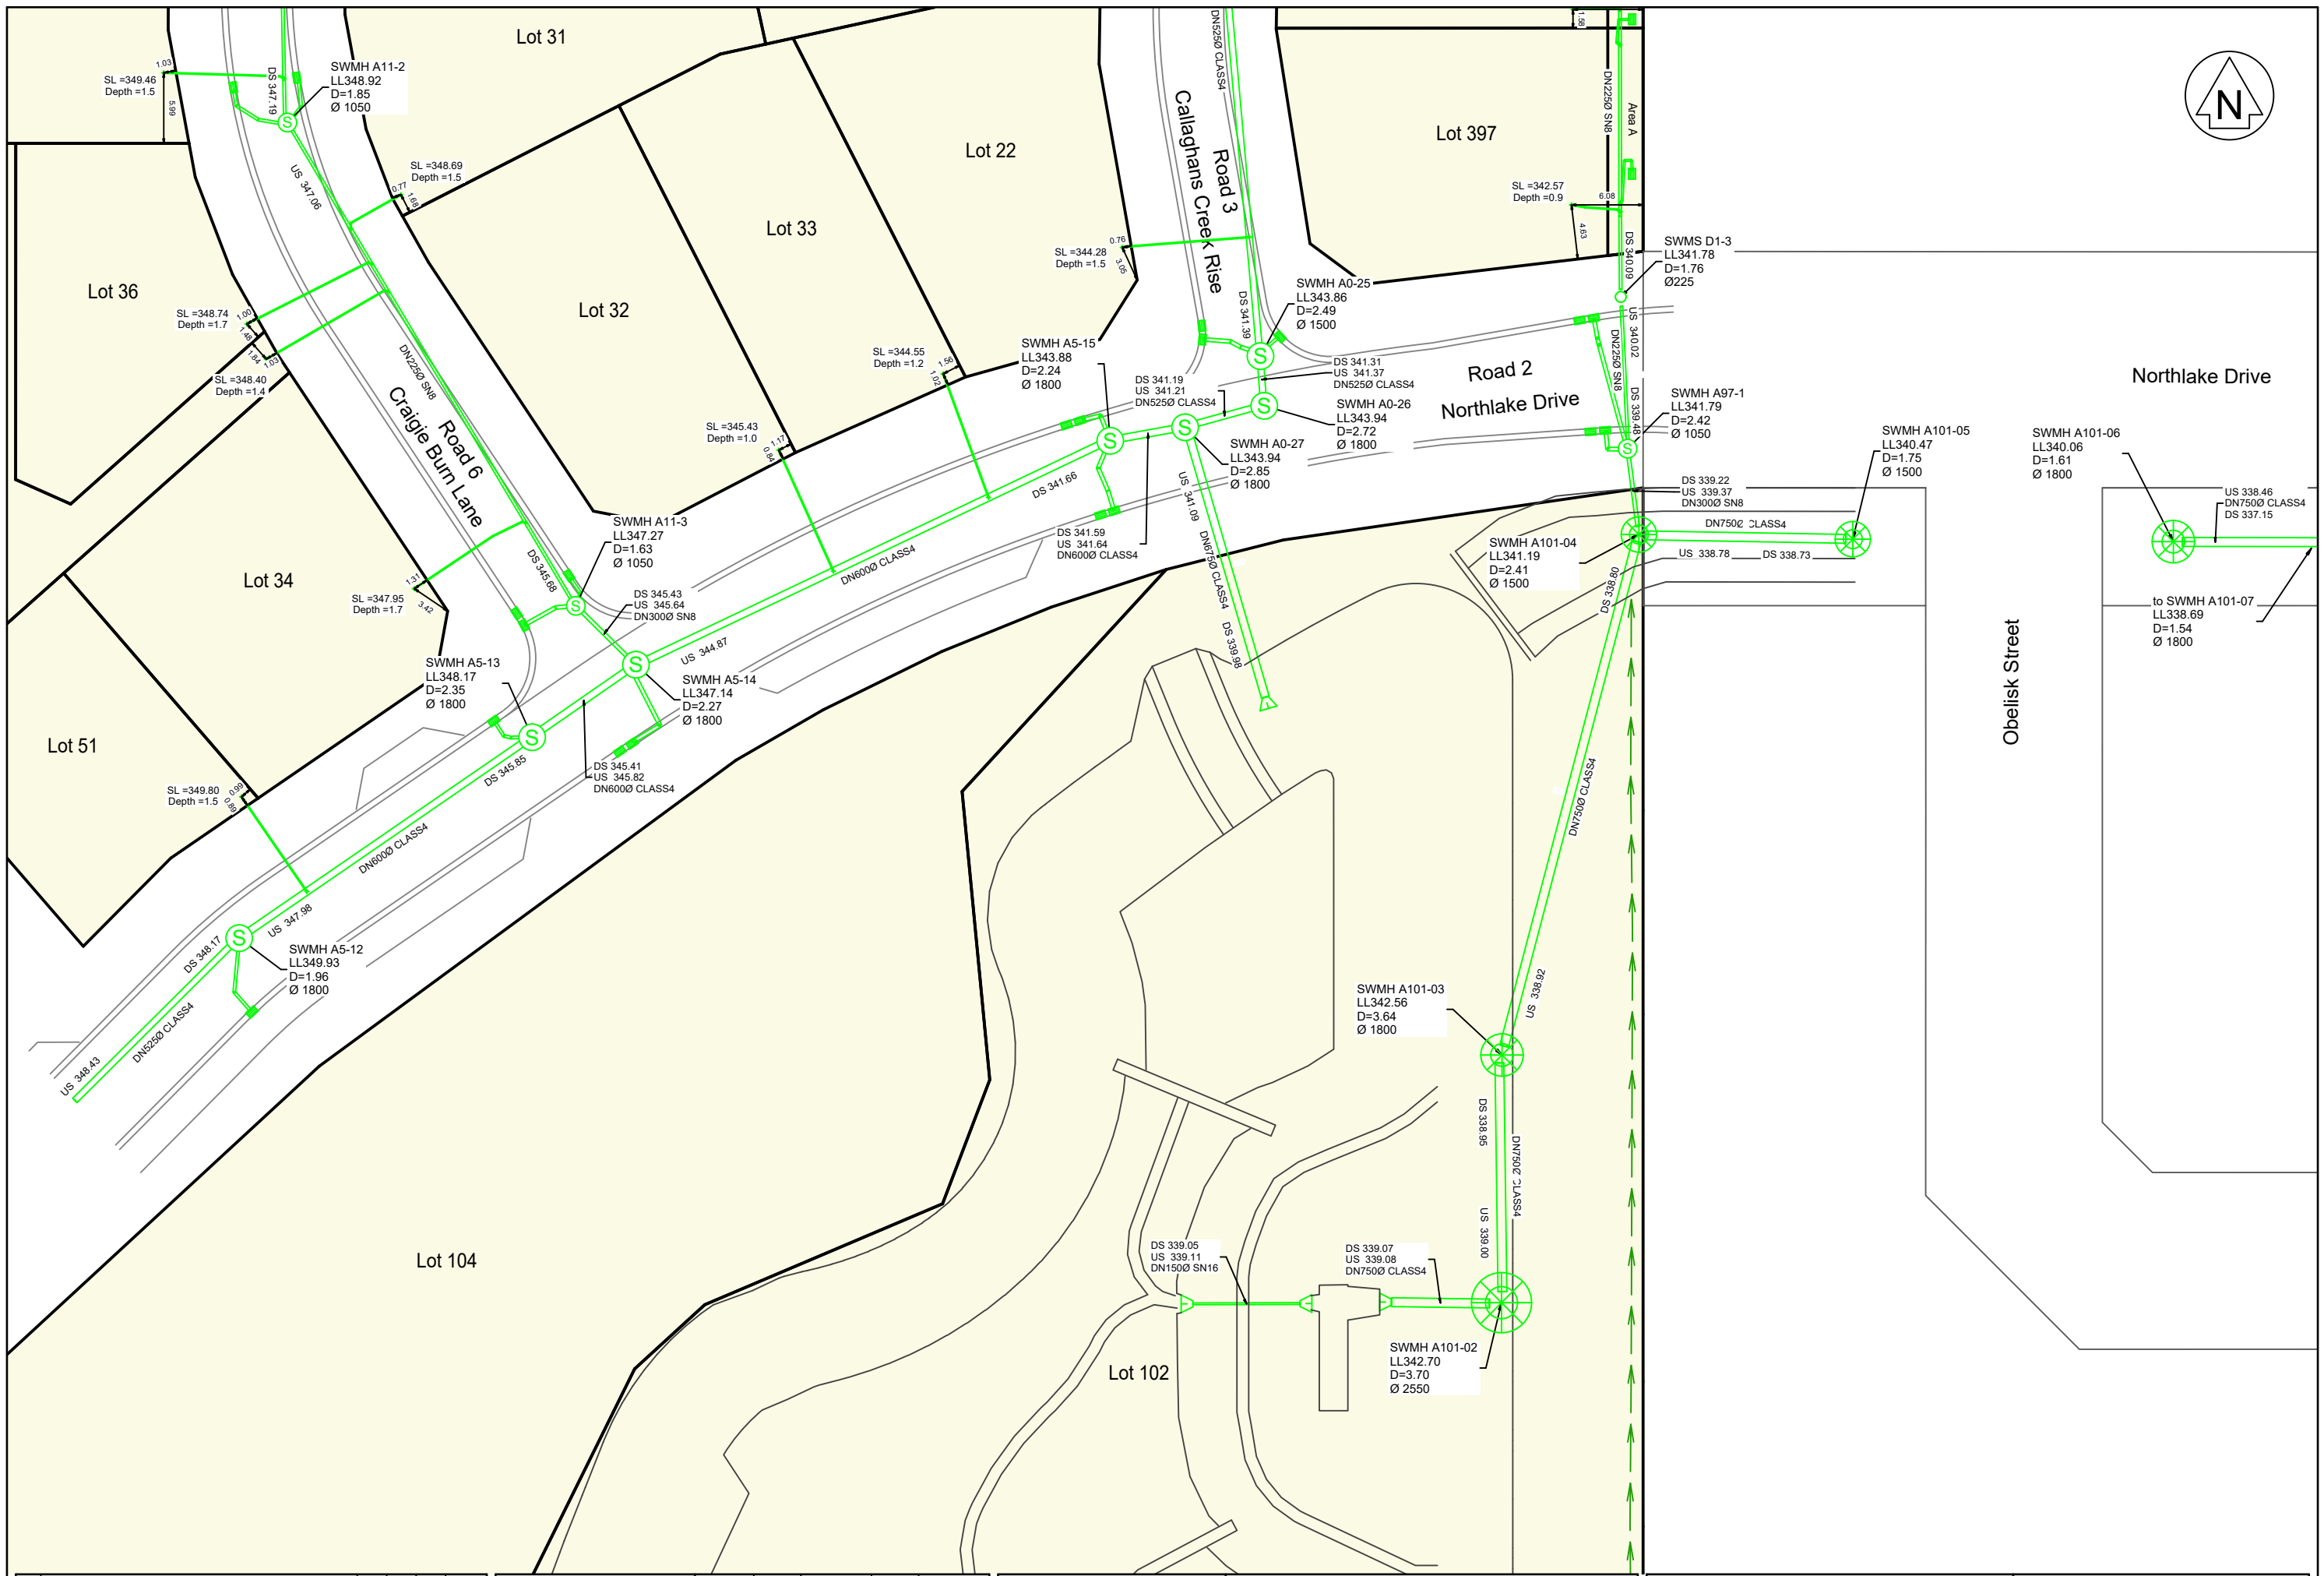

|     |               |  |    |     |          |
|-----|---------------|--|----|-----|----------|
|     |               |  |    |     |          |
|     |               |  |    |     |          |
| 1   | Initial Issue |  | KA | NKA | NKA      |
| No. | Revision      |  | By | Chk | Appd     |
|     |               |  |    |     | Date     |
|     |               |  |    |     | 19/05/25 |

Plotted By: kat

DO NOT SCALE - IF IN DOUBT ASK

|                     |                   |                             |
|---------------------|-------------------|-----------------------------|
| Original Scale (A1) | Drawn By K Adams  | Checked By N Archer         |
| Reduced Scale (A3)  | Coordinate System | Lindis Peak 2000 EPSG:2127  |
| 1 : 500             | Origin Name       | F6LK                        |
|                     | Origin Coordinate | 806736.288 mN 375397.584 mE |
|                     | Origin of Levels  | 338.832 m VD2016            |

Client:

**LANDPRO.**

Project:

21091 Stage 1 As-Built Stormwater  
RM220913

Title:

WFH Properties Ltd  
Pembroke Heights  
Wanaka

Discipline

Stormwater Page 2 of 2

Drawing No.



204

Rev.

1

Drawing Plotted: Fri May 30 14:23:52 2025

Document No: c:\125\SiteData\SERVER\2008\21091-WFH Properties Ltd - Wanaka Development\_390112\21091 Stage 1 As Built Stormwater\_12model Document Path: 21091 Stage 1 As Built Stormwater

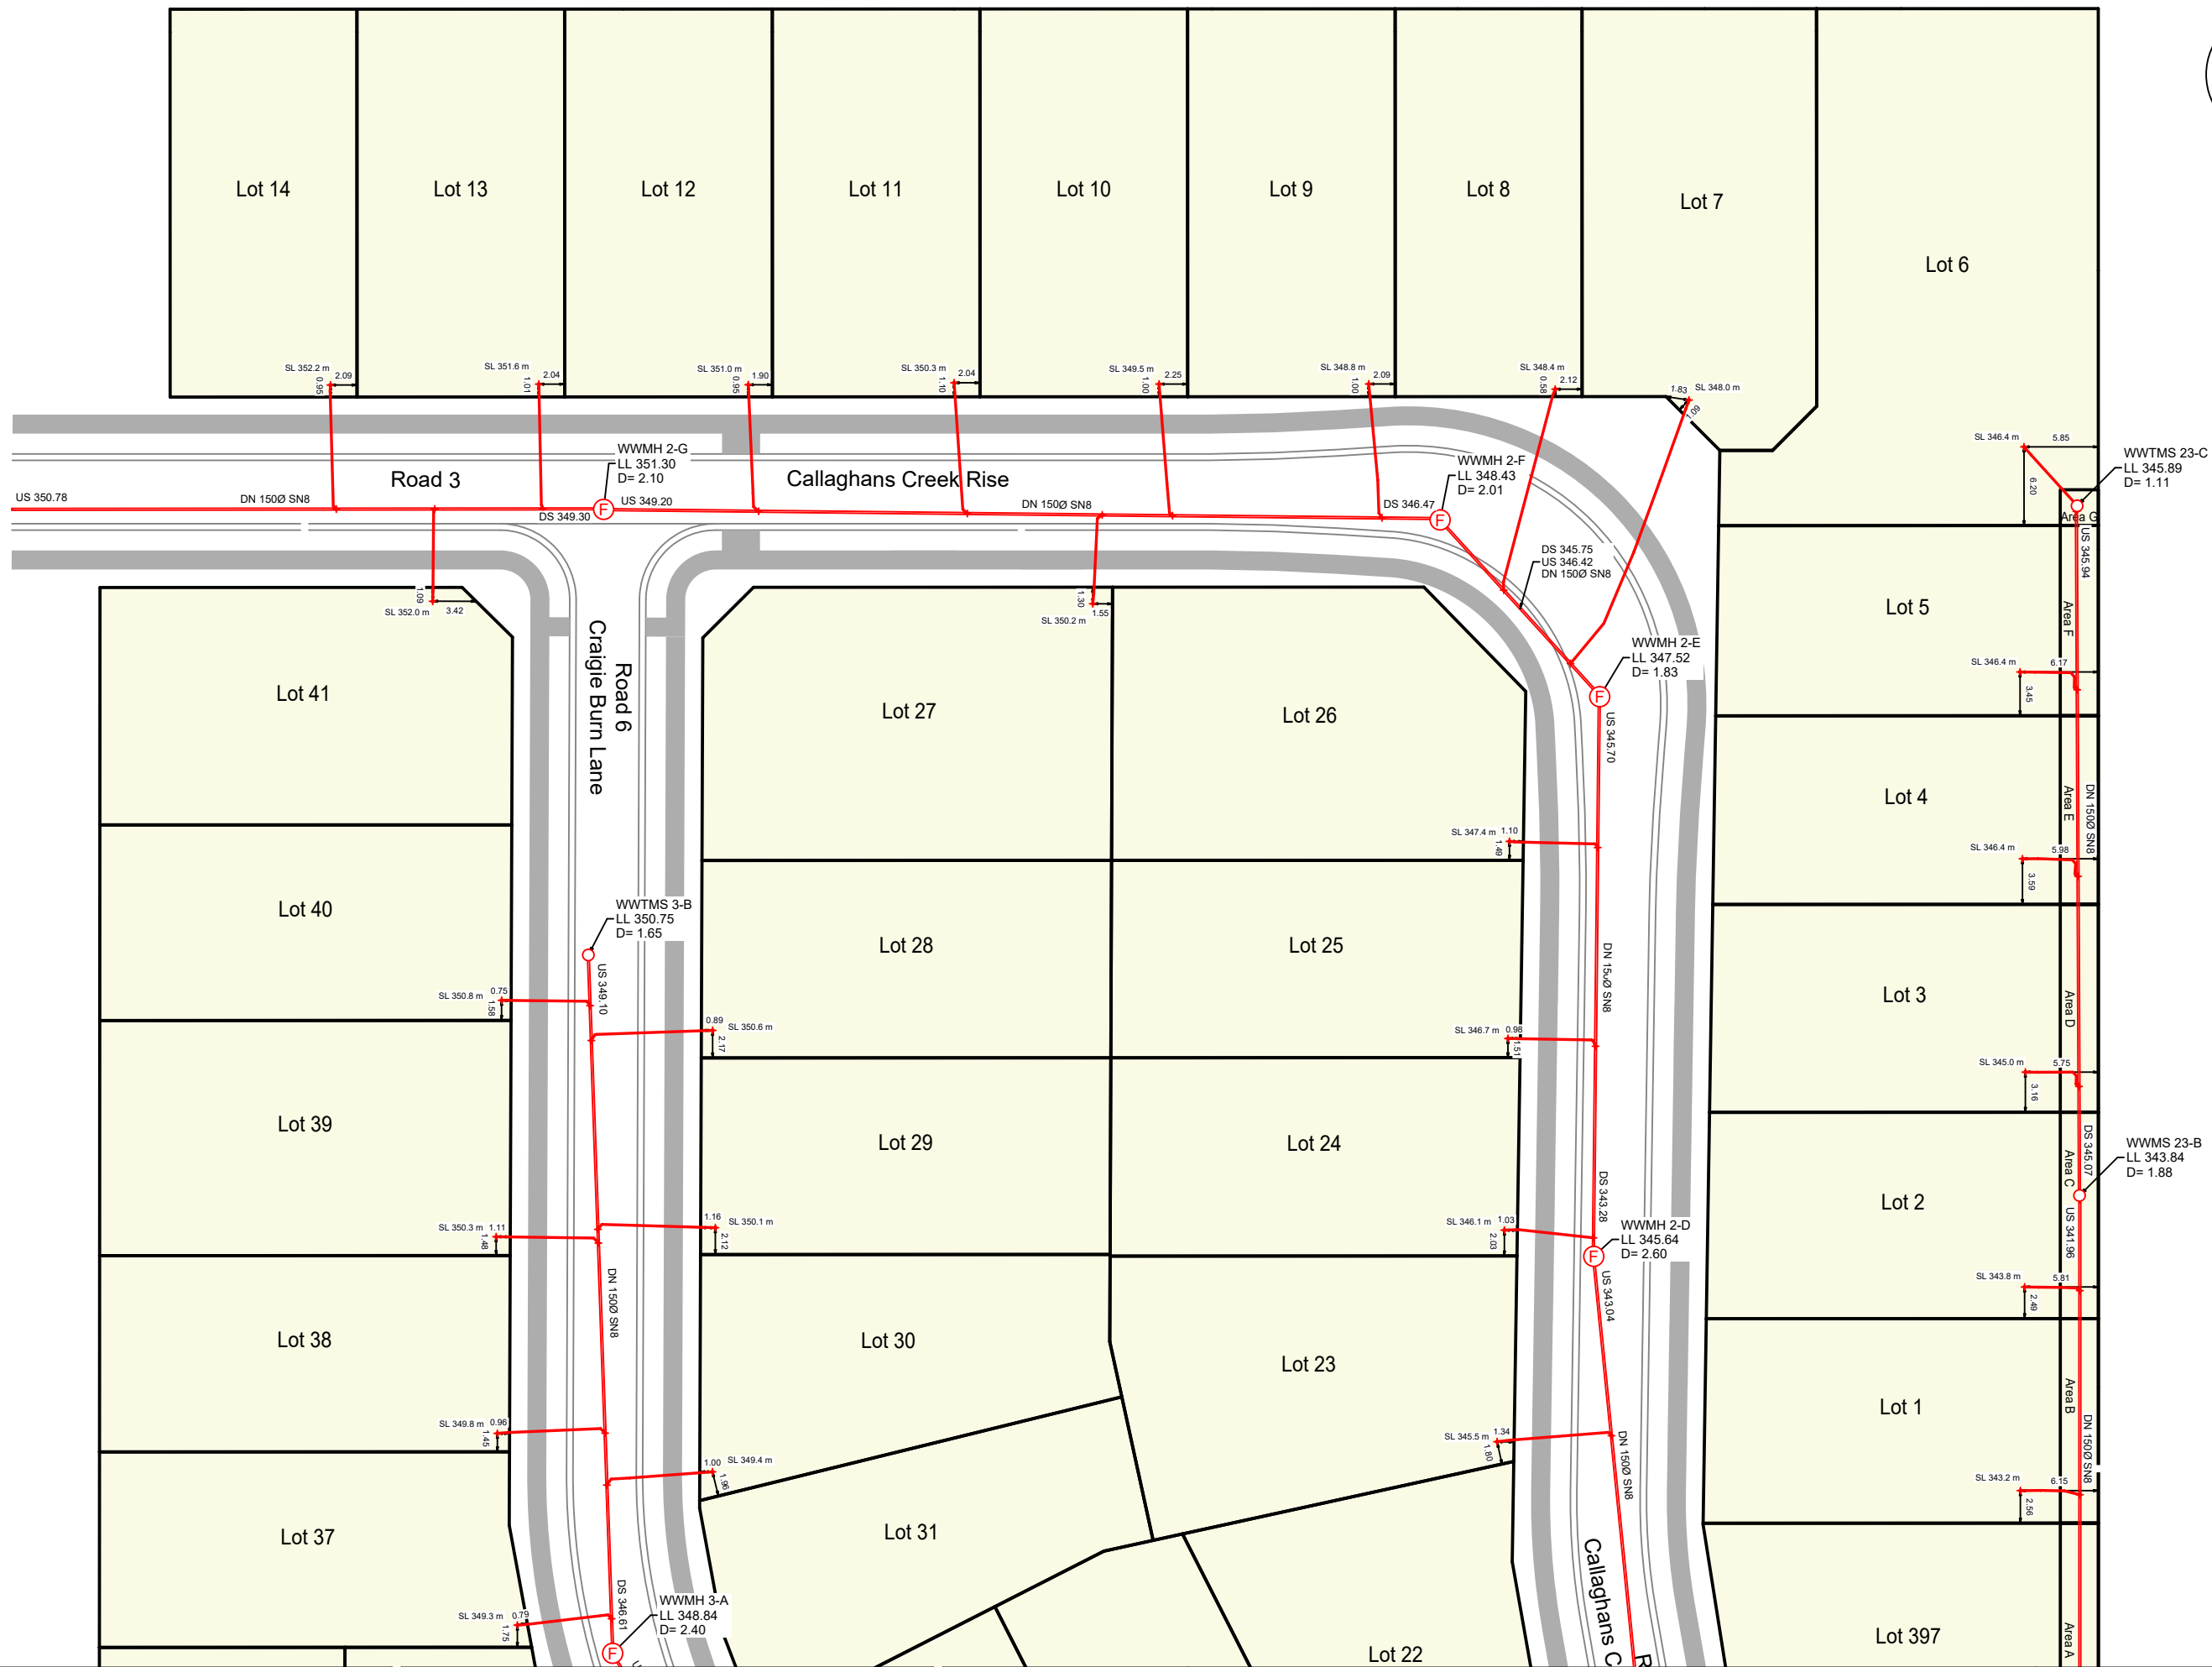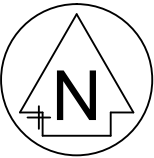

|     |               |  |    |     |          |
|-----|---------------|--|----|-----|----------|
|     |               |  |    |     |          |
|     |               |  |    |     |          |
| 1   | Initial Issue |  | KA | NKA | NKA      |
| No. | Revision      |  | By | Chk | Appd     |
|     |               |  |    |     | Date     |
|     |               |  |    |     | 19.05.25 |



|                     |                   |                             |
|---------------------|-------------------|-----------------------------|
| Original Scale (A1) | Drawn By K Adams  | Checked By N Archer         |
| Reduced Scale (A3)  | Coordinate System | Lindis Peak 2000 EPSG:2127  |
| 1 : 500             | Origin Name       | PIN 1 SO 559636             |
|                     | Origin Coordinate | 806736.288 mN 375397.584 mE |
|                     | Origin of Levels  | 338.832 m VD2016            |



Client: 21091 Stage 1 As-Built Wastewater RM220913

Title: WFH Properties Ltd  
Pembroke Heights  
Wanaka

|             |       |             |
|-------------|-------|-------------|
| Discipline  | Sewer | Page 1 of 2 |
| Drawing No. | 205   | Rev. 1      |

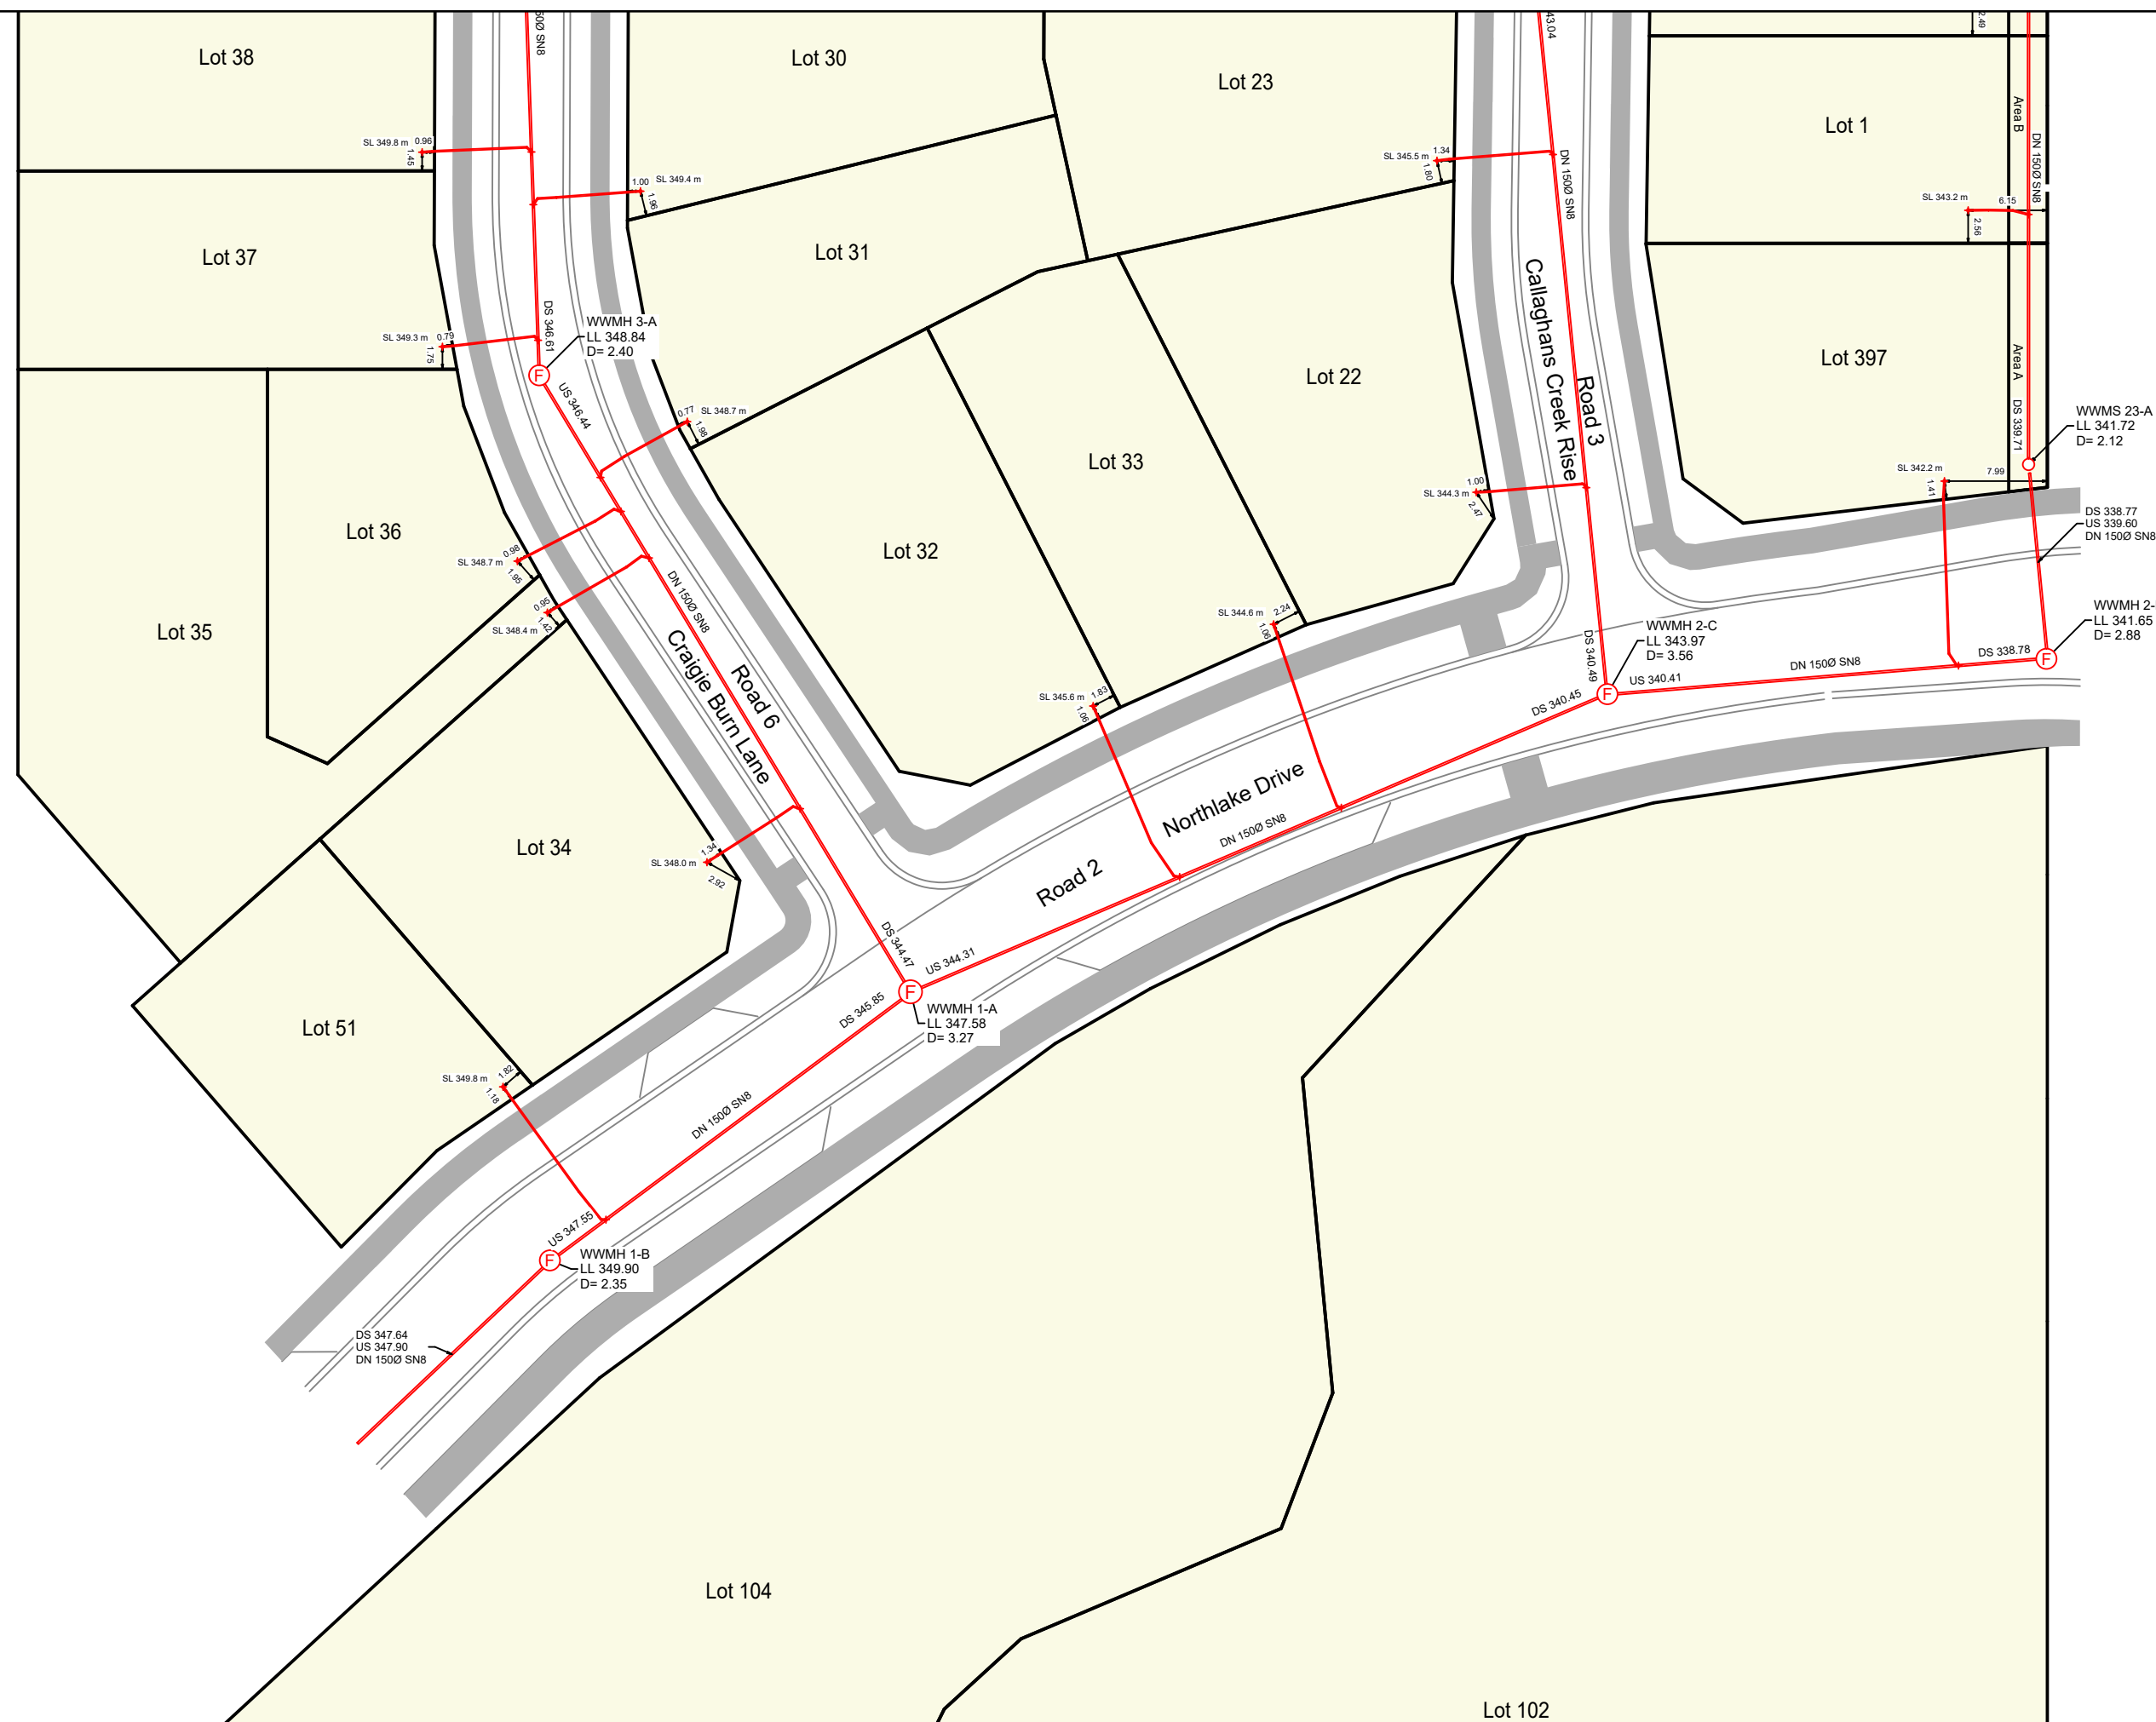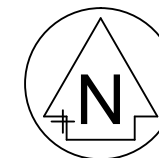

|     |               |    |     |              |
|-----|---------------|----|-----|--------------|
|     |               |    |     |              |
|     |               |    |     |              |
|     |               |    |     |              |
| 1   | Initial Issue | KA | NKA | NKA 19.05.25 |
| No. | Revision      | By | Chk | Appd Date    |

|                                  |                    |         |                               |          |
|----------------------------------|--------------------|---------|-------------------------------|----------|
| Original<br>Scale (A1)           | Drawn By           | K Adams | Checked By                    | N Archer |
|                                  | Coordinate System  |         | Lindis Peak 2000 EPSG:2127    |          |
| Reduced<br>Scale (A3)<br>1 : 500 | Origin Name        |         | PIN 1 SO 559636               |          |
|                                  | Origin Coordinate  |         | 806736.288 m N 375397.584 m E |          |
|                                  | Origin of 1 levels |         | 338.832 m VD2016              |          |

Client

**LANDPRO.**

Project:

21091 Stage 1 As-Built Wastewater  
RM220913

|     | Title |
|-----|-------|
| 1   |       |
| 2   |       |
| 3   |       |
WFH Properties Ltd  
Pembroke Heights  
Wanaka

|  |            |  |
|--|------------|--|
|  |            |  |
|  | Discipline |  |


Page 2 of 2

Drawing No.

205

Re



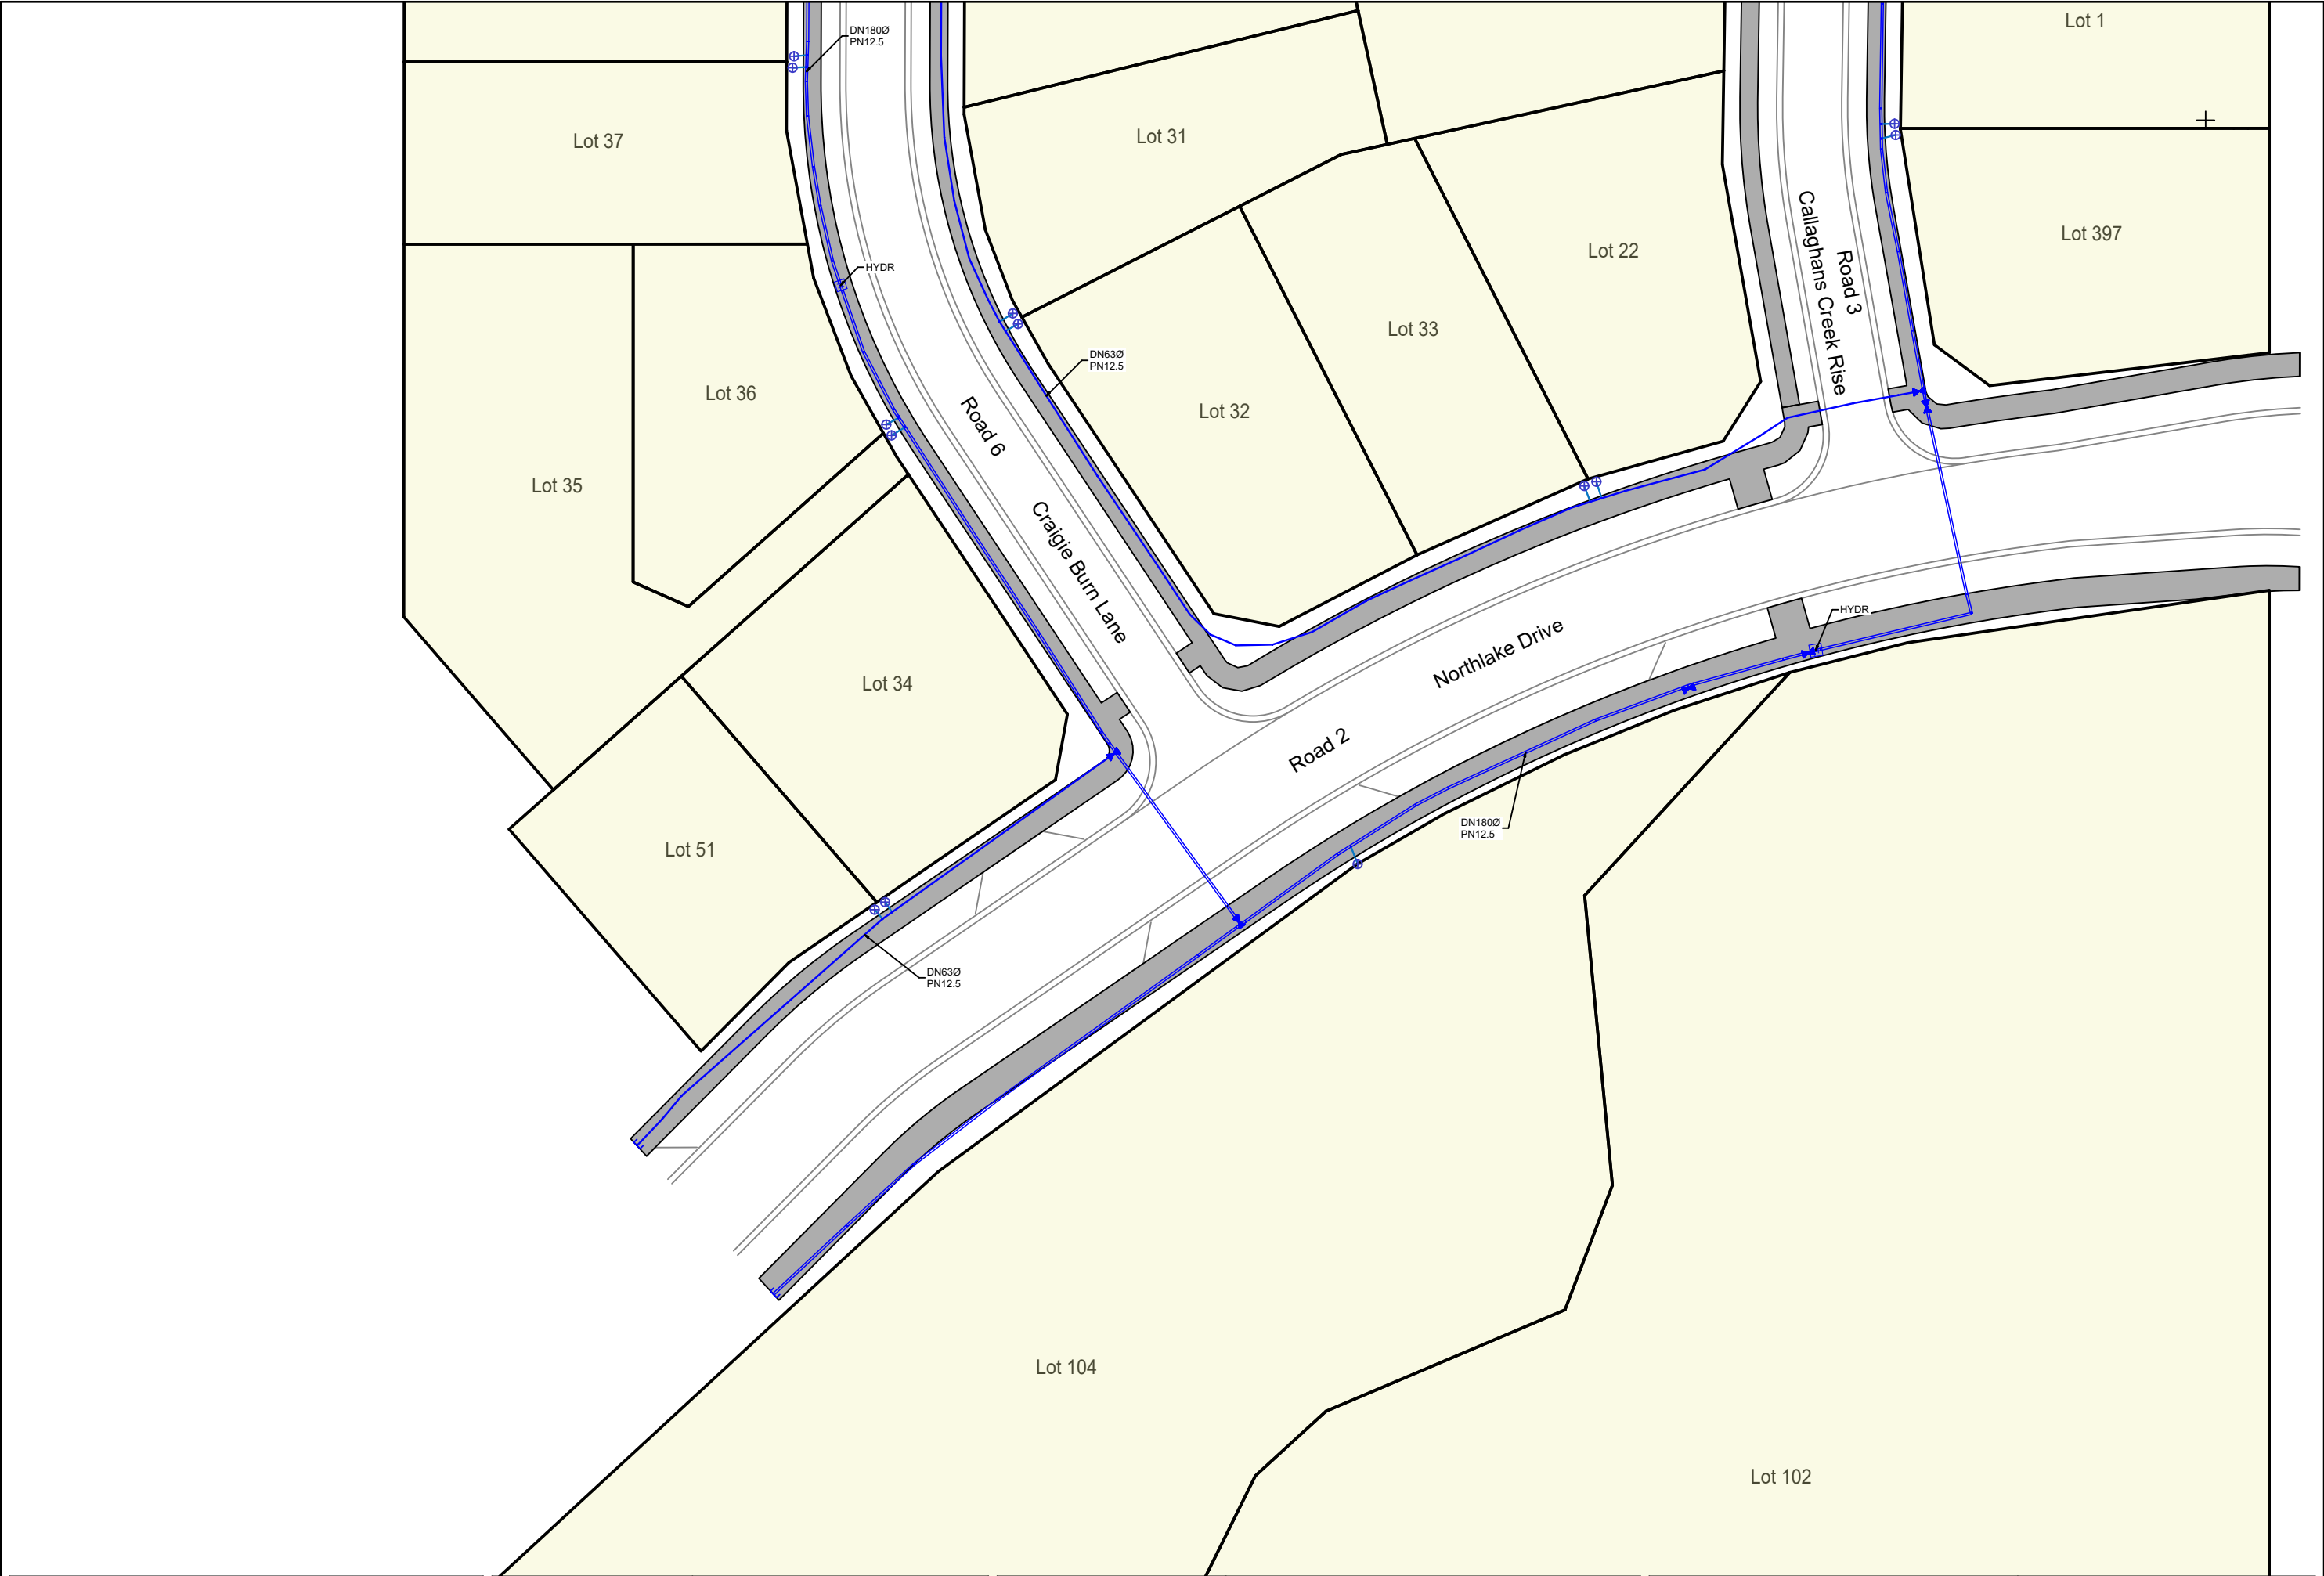

|     |               |  |    |     |      |          |  |
|-----|---------------|--|----|-----|------|----------|--|
|     |               |  |    |     |      |          |  |
| 1   | Initial Issue |  | KA | NKA | NKA  | 23.05.25 |  |
| No. | Revision      |  | By | Chk | Appd | Date     |  |

|                     |                   |                             |
|---------------------|-------------------|-----------------------------|
| Original Scale (A1) | Drawn By K Adams  | Checked By N Archer         |
| Reduced Scale (A3)  | Coordinate System | Lindis Peak 2000 EPSG:2127  |
| 1 : 500             | Origin Name       | PIN 1 SO 559636             |
|                     | Origin Coordinate | 806736.288 mN 375397.584 mE |
|                     | Origin of Levels  | 338.832 m VD2016            |

|                 |                                               |
|-----------------|-----------------------------------------------|
| Client:         | Project:                                      |
| <b>LANDPRO.</b> | 21091 Stage 1 As-Built Potable Water RM220913 |

|             |                                                  |
|-------------|--------------------------------------------------|
| Title:      | WFH Properties Ltd<br>Pembroke Heights<br>Wanaka |
| Drawing No. | 206                                              |

|            |       |             |
|------------|-------|-------------|
| Discipline | Water | Page 2 of 2 |
| Rev.       | 1     |             |